

Addendum 3, Solicitation No. 11-A016

LITTLE TALLAPOOSA PARK PHASE I WATER AND SANITARY SEWER

The Carroll County Board of Commissioners submits Addendum 3 to Solicitation No. 11-A016, **LITTLE TALLAPOOSA PARK PHASE I WATER AND SANITARY SEWER**. Please read and review the attachment carefully.

CLARIFICATIONS, ADDITIONS AND REVISIONS

1. Proposals are still due 2:00 pm, Wednesday, May 25, 2011.
2. Please review the attached Addendum which includes updated drawings.
3. The updated Plan Holders List has been added to the County's website at www.carrollcountyga.com/pages/purchasing.
4. Project information may be obtained by contacting the Purchasing Department at 770-830-5868, email: rbenedict@carrollcountyga.com or by visiting the County's website at www.carrollcountyga.com/pages/purchasing.

All other Specifications, Terms and Conditions, not affected by the above changes and additions, remain in effect. Bidders shall acknowledge receipt of this addendum on the Bid Form in their bid packages. Proposals without this acknowledgement may be rejected.

R. Benedict
Purchasing Manager
(770) 830-5868
rbenedict@carrollcountyga.com

Addendum No. 3

Little Tallapoosa Park Phase 1
(Water and Sanitary Sewer)
Solicitation Number 11-A016
Carroll County Board of Commissioners

May 20, 2011

Addendum No. 3 consists of four (4) letter-size (8½" x 11") sheets.

Addendum No. 3 consists of clarifications, additions, and/or revisions to the Contract Documents and is hereby made a part of those Contract Documents.

1. Proposals are still due at 2:00 p.m., Wednesday, May 25, 2011.
2. Carroll County is the Primary Permittee for erosion control and NPDES permitting on this project. The Utility Contractor that is awarded this job will be considered the Operator for the Primary Permittee, and will be required to perform all erosion control/storm water inspection, monitoring, and reporting required by EPD for the Primary Permittee. These are the same responsibilities that are currently imposed on the Grading Contractor. The Utility Contractor will take over these responsibilities when the Grading Contractor is released from the site, and we will swap these responsibilities from the Grading Contractor to the Utility Contractor as mentioned in Item 3 of Addendum No. 2. The cost for all required inspection, monitoring, and reporting should be entered into Line 41 of the Bid Form.
3. If needed, the Project Engineer may provide the Utility Contractor with templates for the erosion control/storm water inspection and monitoring forms. However, the Utility Contractor WILL BE responsible for performing all inspection, monitoring, and reporting including distributing reports to EPD (only those required by EPD), the Project Engineer, and Carroll County.
4. The water system installer must be approved by Carroll County Water Authority prior to bid acceptance.
5. All bids MUST include the appropriate Construction Contingency Allowance in the base bid amount. If a Bidder submits a bid for Division 1 only, then his/her bid must include the Construction Contingency Allowance for Division 1 (\$15,000) in the based bid. If a Bidder submits a bid for Division 2 only, then his/her bid must include the Construction Contingency Allowance for Division 2 (\$10,000). If a Bidder submits bids for both Division 1 and Division 2, then his/her bids must each contain the Construction Contingency Allowance that is appropriate to the Division.
6. Contractor shall add a line item in the Bid Form in Item 43 "Miscellaneous Items" for installation of 6" Schedule 40 PVC for that shown in the septic systems on the plans.
7. Bidders may receive a PDF of the bid set plans by contacting the Project Engineer.
8. The scope of work for the water system DOES include all work within GA Hwy 113 (tie-in to existing water system, jacking and boring, etc.). Carroll County Water Authority is

only assisting the County with the permit process required by Georgia Department of Transportation.

9. See attached plans for revisions and additional information.


End of Addendum No. 3

NO.	DATE	REVISIONS
1	05-20-11	REVISED WATER MAIN BORE AT HWY 113 PER GDOT COMMENTS

GEORGIA AND WEST, INC.
 ENGINEERING, LAND SURVEYING & LAND PLANNING
 105 CORPORATE DRIVE
 CARROLLTON, GA. 30117
 E-MAIL: mailbox@georgiandwest.com
 OFFICE (770) 834-4694
 FAX (770) 834-1005

TITLE: GDOT UTILITY ENCROACHMENT PLAN
 CARROLL COUNTY
 LITTLE TALLAPOOSA PARK PH. 1
 LOCATED IN 209 & 210, 5th DISTRICT
 CARROLL COUNTY, GEORGIA

SCALE:	DATE	JOB NUMBER	DESIGNED BY
1"=30'	05-12-11	10-05-13	JDB

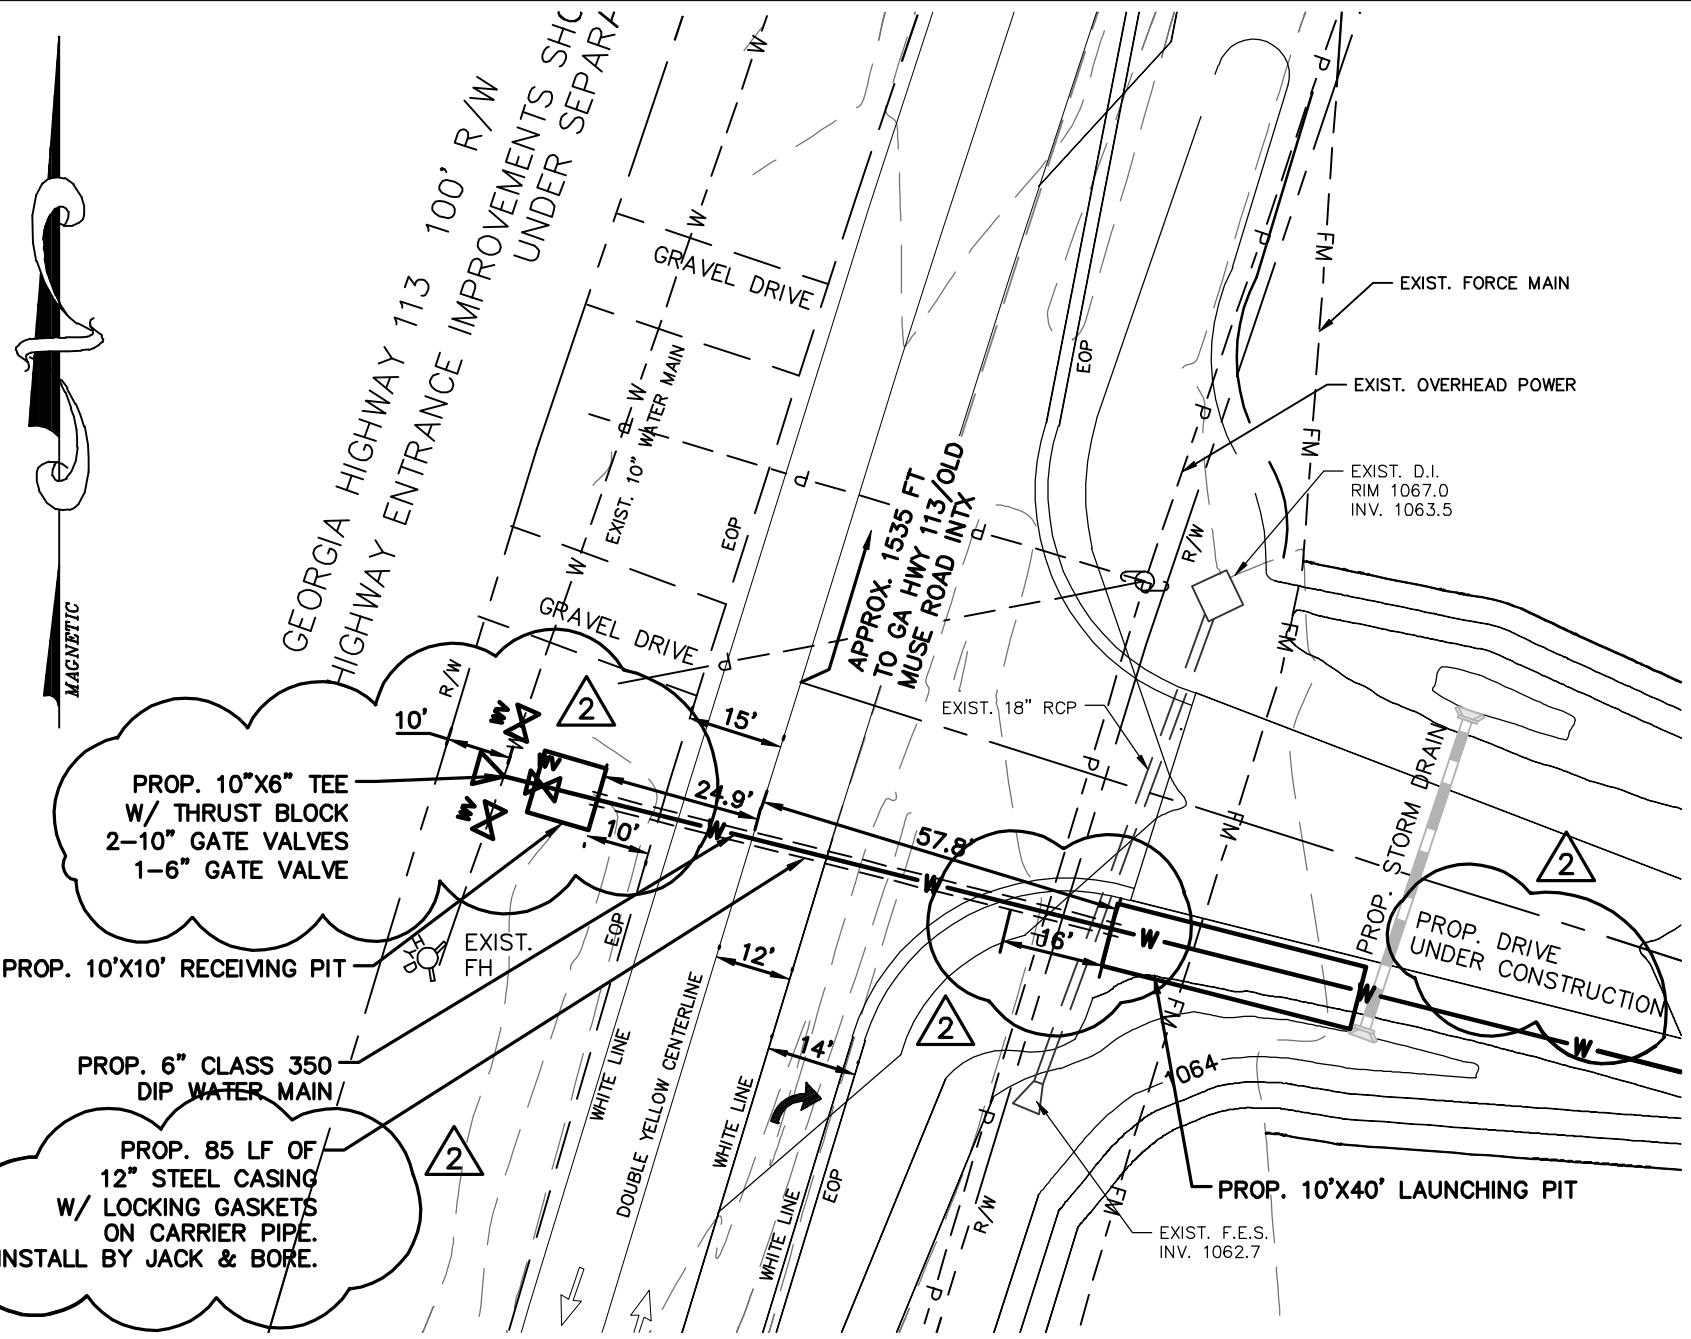


WARNING: THIS PLAN SHEET IS NOT THE OFFICIAL CONTRACT DOCUMENT UNLESS APPROVED BY THE APPROPRIATE GOVERNMENTAL AGENCIES.

WARNING: UTILITIES LOCATIONS ARE APPROXIMATE. BEWARE OF HIDDEN UTILITIES NOT SHOWN. CONTACT APPROPRIATE UTILITY COMPANIES PRIOR TO EXCAVATION.

NOTICE: IT IS THE PROPERTY OWNER'S/ CONTRACTOR'S RESPONSIBILITY TO COMPLY WITH ALL ENVIRONMENTAL IMPACT ISSUES AND TO OBTAIN ALL NECESSARY PERMITS FROM THE APPROPRIATE GOVERNING AUTHORITIES.



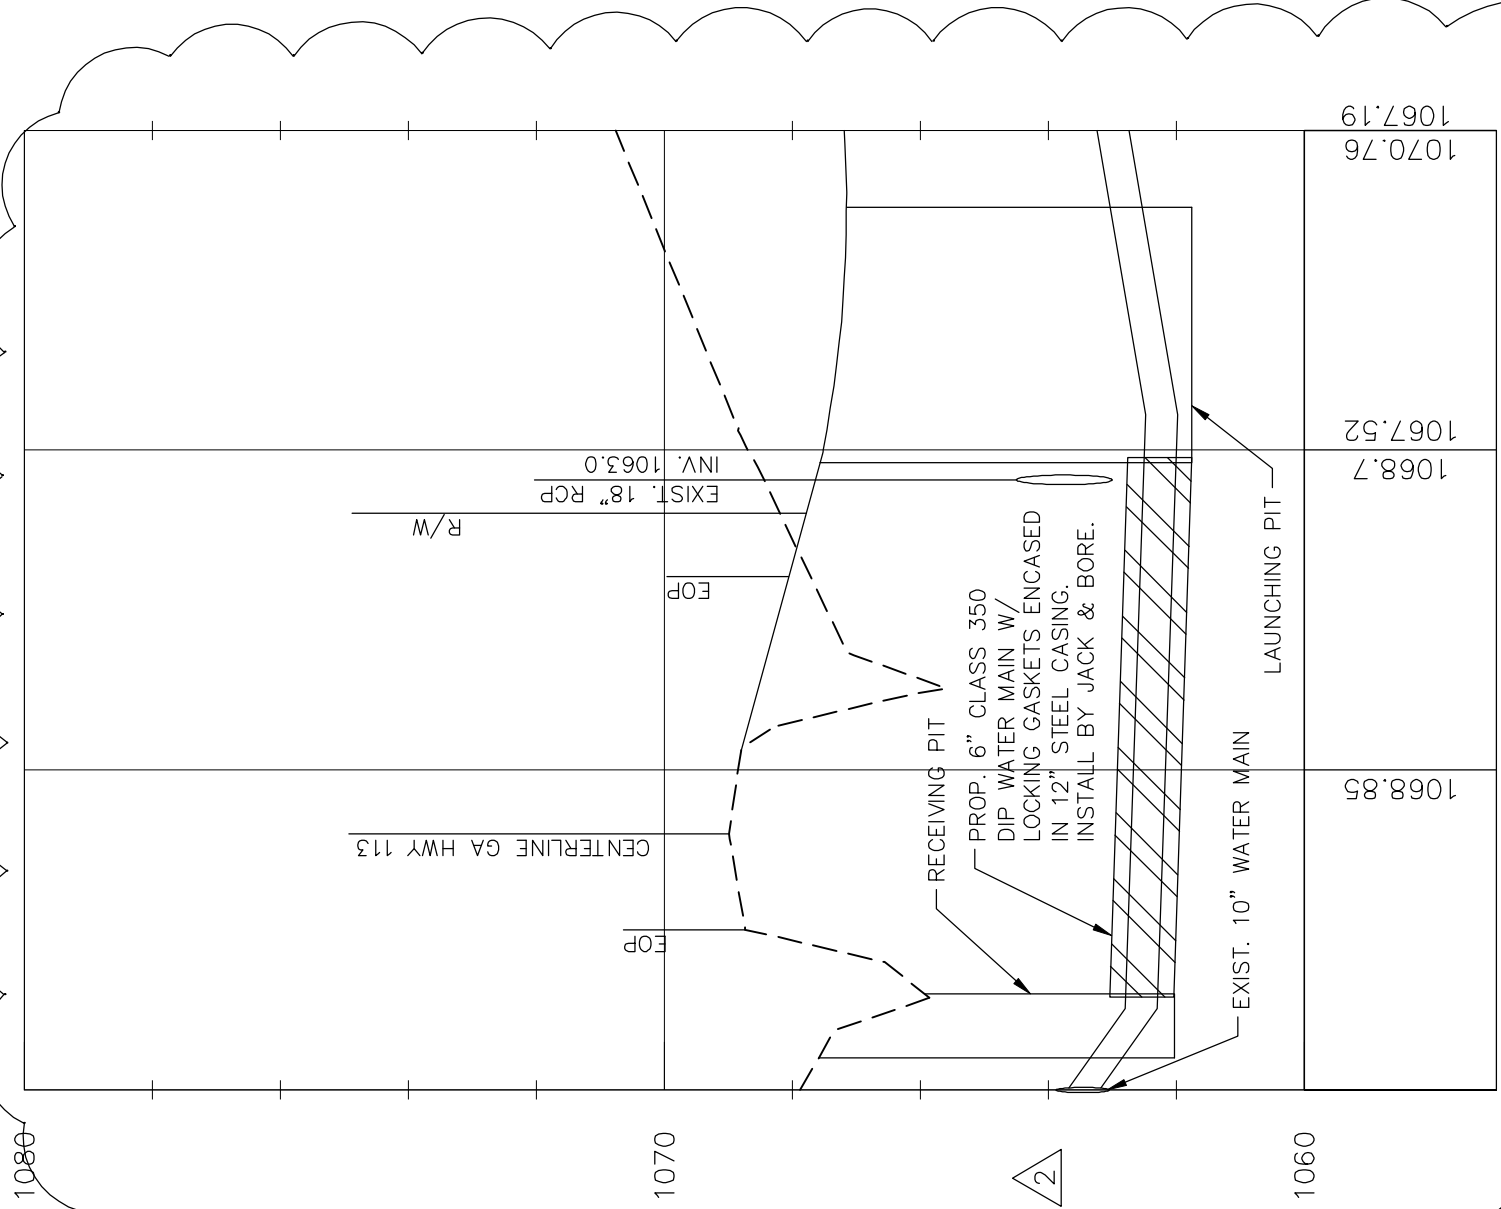

WATER LINE @ HWY. 113

SCALE: VERT: 1" = 3'
HORIZ: 1" = 30'

TITLE: GDOT UTILITY ENCROACHMENT PROFILE
 CARROLL COUNTY
 LITTLE TALLAPOOSA PARK PH. 1
 LOCATED IN 209 & 210, 5th DISTRICT
 CARROLL COUNTY, GEORGIA

GEORGIA AND WEST, INC.
 ENGINEERING, LAND SURVEYING & LAND PLANNING
 105 CORPORATE DRIVE
 CARROLLTON, GA. 30117
 E-MAIL: mailbox@georgiandwest.com
 OFFICE (770) 834-4694
 FAX (770) 834-1005

NO.	DATE	REVISIONS
1	05-20-11	REVISED WATER MAIN BORE AT HWY 113 PER GDOT COMMENTS

WARNING: THIS PLAN SHEET IS NOT THE OFFICIAL CONTRACT DOCUMENT UNLESS APPROVED BY THE APPROPRIATE GOVERNMENTAL AGENCIES.

WARNING: UTILITIES LOCATIONS ARE APPROXIMATE. BEWARE OF HIDDEN UTILITIES NOT SHOWN. CONTACT APPROPRIATE UTILITY COMPANIES PRIOR TO EXCAVATION.

NOTICE: IT IS THE PROPERTY OWNER'S/ CONTRACTOR'S RESPONSIBILITY TO COMPLY WITH ALL ENVIRONMENTAL IMPACT ISSUES AND TO OBTAIN ALL NECESSARY PERMITS FROM THE APPROPRIATE GOVERNING AUTHORITIES.

